

ISABELLA COUNTY  
APPLICATION FOR SITE PLAN REVIEW

**Applicant**

Name: Larry Miller Owner/Agent/Other interest (circle one)

Address: 1323 Clarendon Rd Clare MI

Phone: 989-313-1541 Email Address: \_\_\_\_\_

**Property Owner (if different from applicant)**

Name: Red Hook Properties

Address: 1601 E Maple Rd Clare MI 48617

Phone: 989-386-9000 Email Address: \_\_\_\_\_

**Property Location**

Tax ID Number: 15-001-10-002-00

Job Site Address: \_\_\_\_\_

Township: Vernon Section: T.16W.R.4 Zoning District: \_\_\_\_\_

Detailed Description of Use: Part of the SE 1/4 of the NW 1/4 of  
sec-1 T16N R4W, Vernon Twp Isabella County Beg 5  
Along the N/S 1/4 line 1363.54 Ft from the W 1/4 cor of sec

Signature: Larry Miller Date: 5-2-25

NOTE: All information received by this department is subject to the Freedom of Information Act. Under this Act, persons are allowed to request copies of said information. This includes, but not limited to, all copyrighted drawings/blueprints.

**\*OFFICE USE ONLY\***

File #: PSPR250007 Fee: \$ 225 Check #: 1141 Receipt #: 15435

Date Received: 5-5-25 Received by: A Johnson

Review Type: Zoning Administrator / Planning Commission Approved [ ] Denied [ ]

Conditions (if any): \_\_\_\_\_




Isabella County Zoning Administrator \_\_\_\_\_ Date \_\_\_\_\_

# SKETCH OF PROPOSED BUILDING

THIS SKETCH BASED ON DIMENSIONS AND SETBACKS AND PREVIOUS SURVEY BY LAPHAM ASSOCIATES PROVIDED BY CLIENT

NOTE:

CURRENT PROPERTY SURVEY RECOMMENDED  
TO ACCURATELY DETERMINE PROPERTY LINES

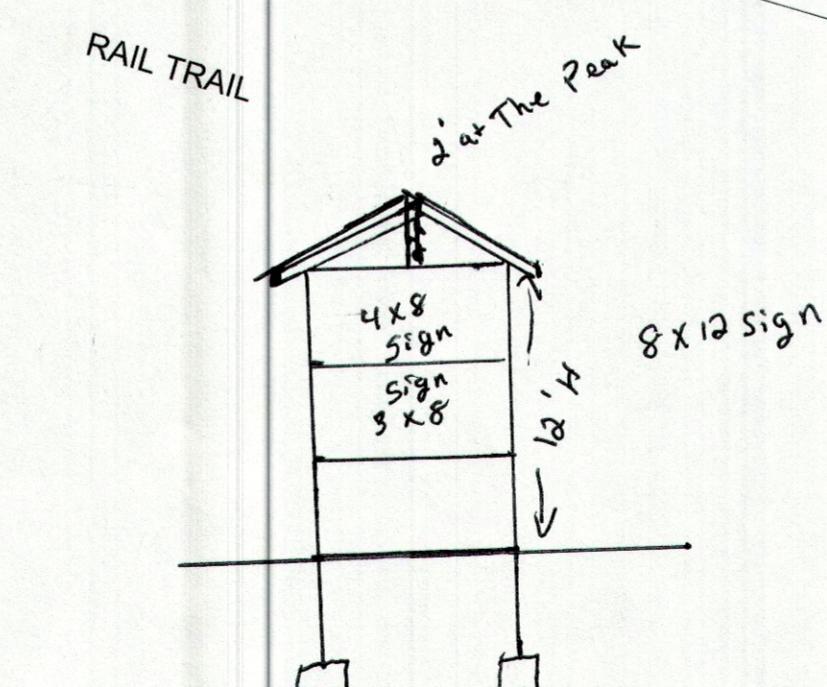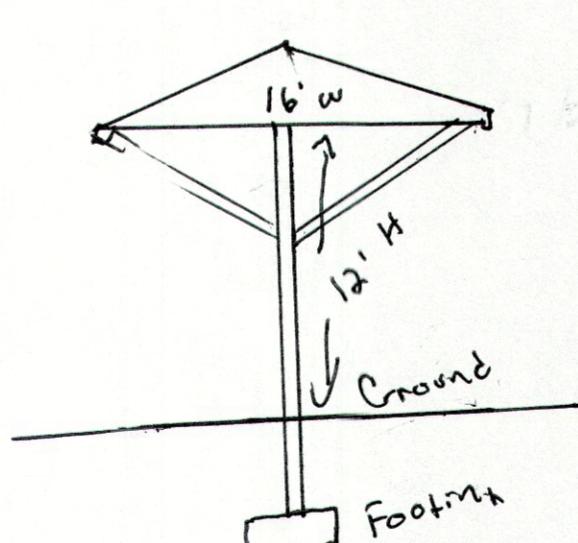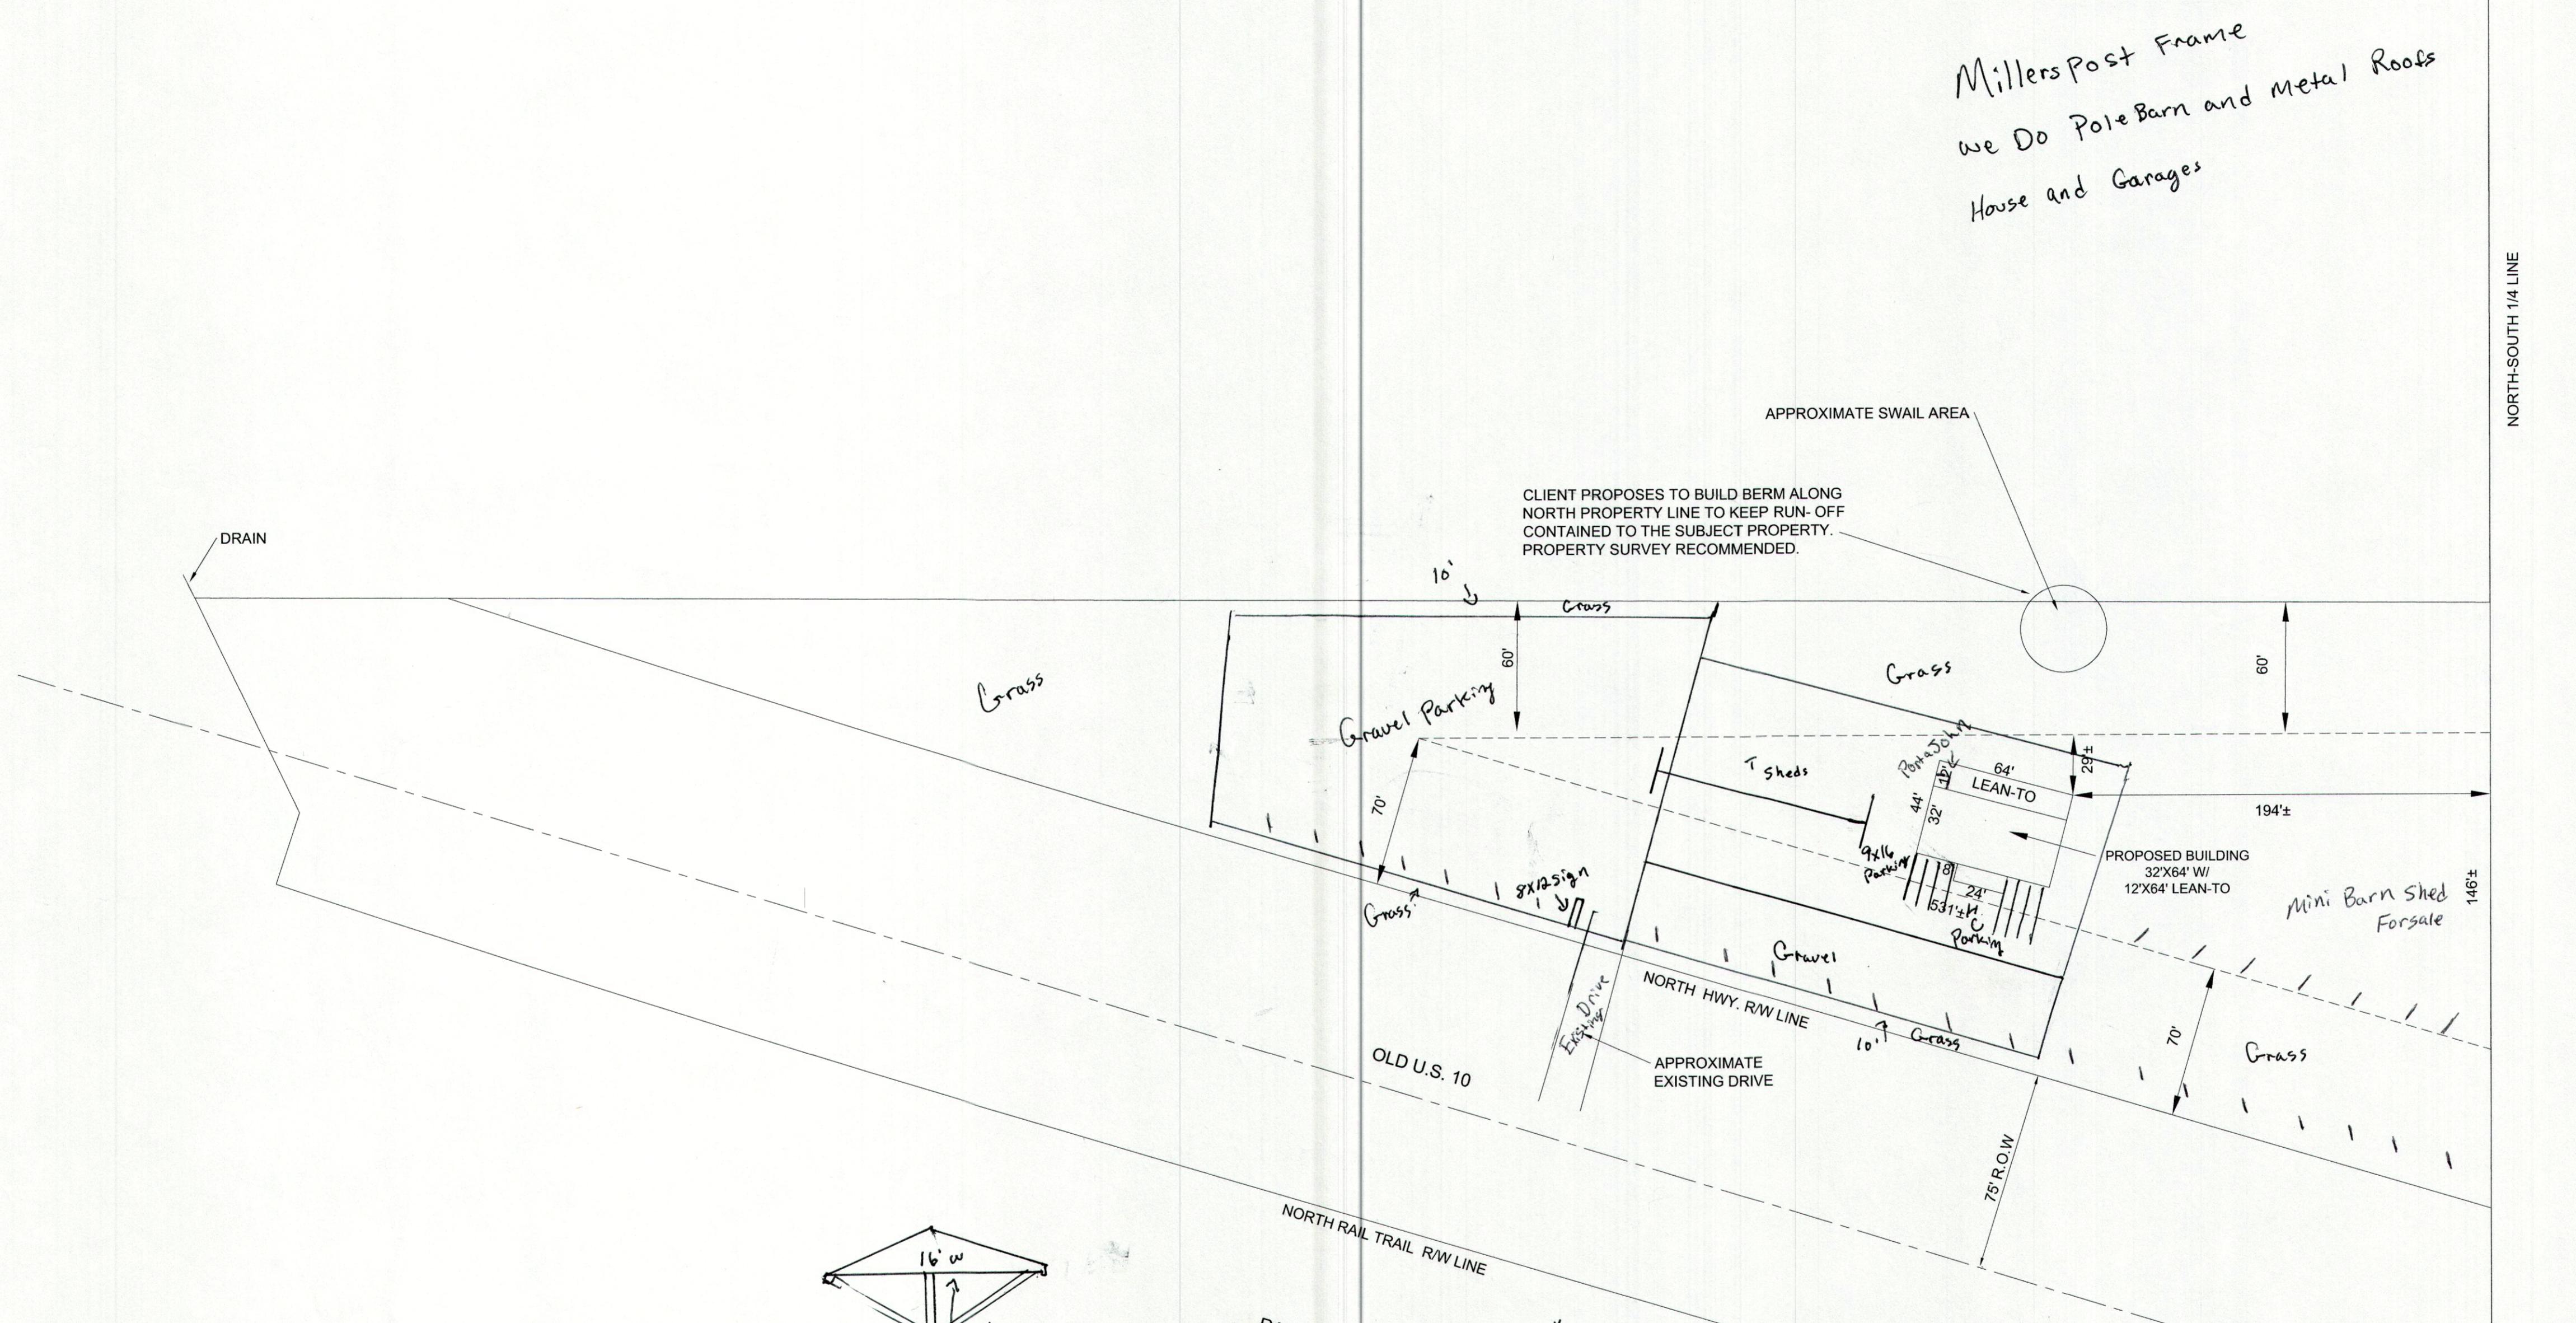

DRAWING FOR:  
**LARRY MILLER**

**LAPHAM** ASSOCIATES  
ENGINEERING PLANNING ENVIRONMENTAL SURVEYING  
5115 East Fifth Street  
Clare, Michigan 48617  
Ph. (989) 386-7774  
Fx. (989) 386-7152  
www.laphamassoc.com  
© 2017 COPYRIGHT LAPHAM ASSOCIATES, INC.  
UNAUTHORIZED COPYING IS PROHIBITED.

0' 25' 50' 100'  
SCALE: 1" = 50'

APPROVED USE FOR:  
 PRELIMINARY  
 CONSTRUCTION  
 FINAL RECORD

A-1